

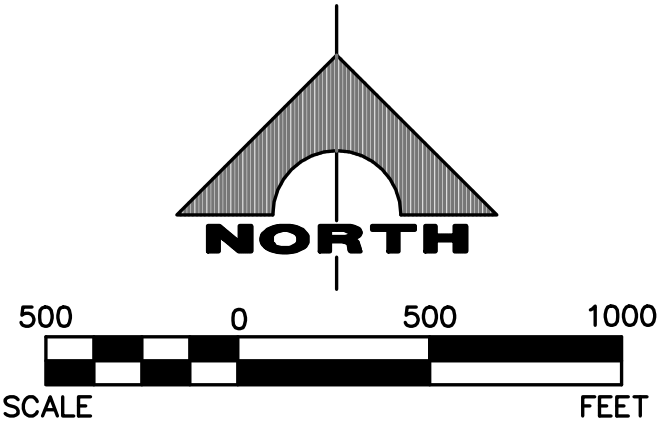
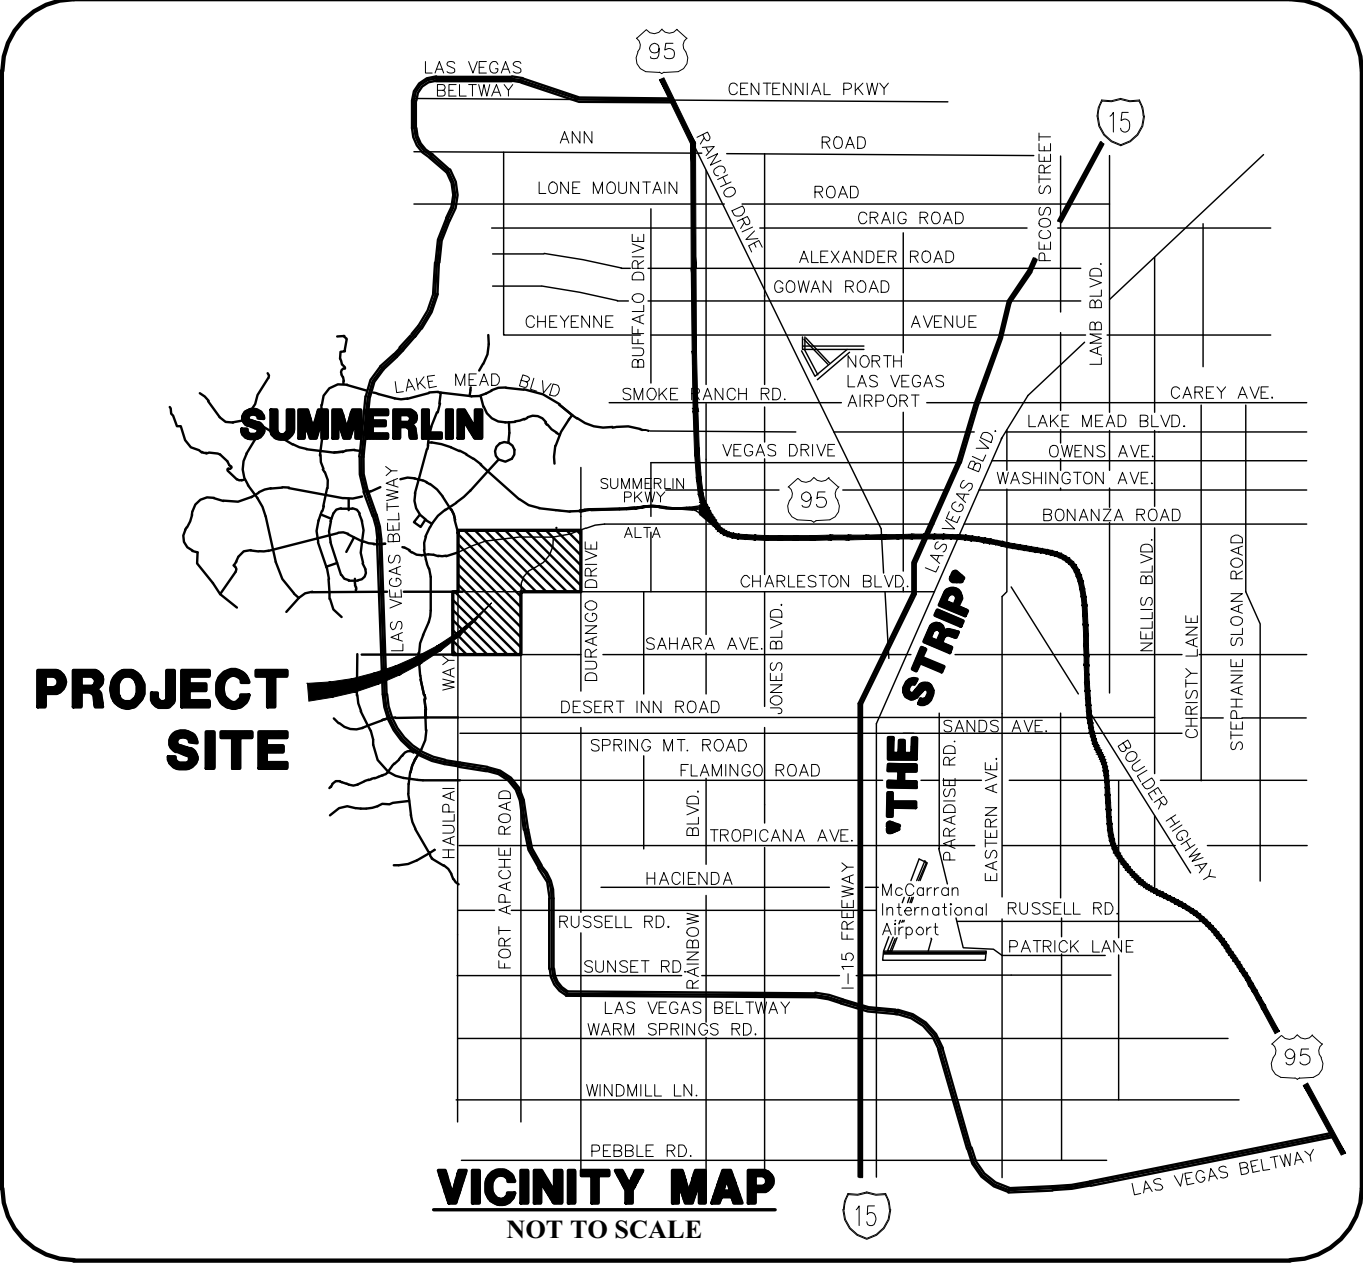


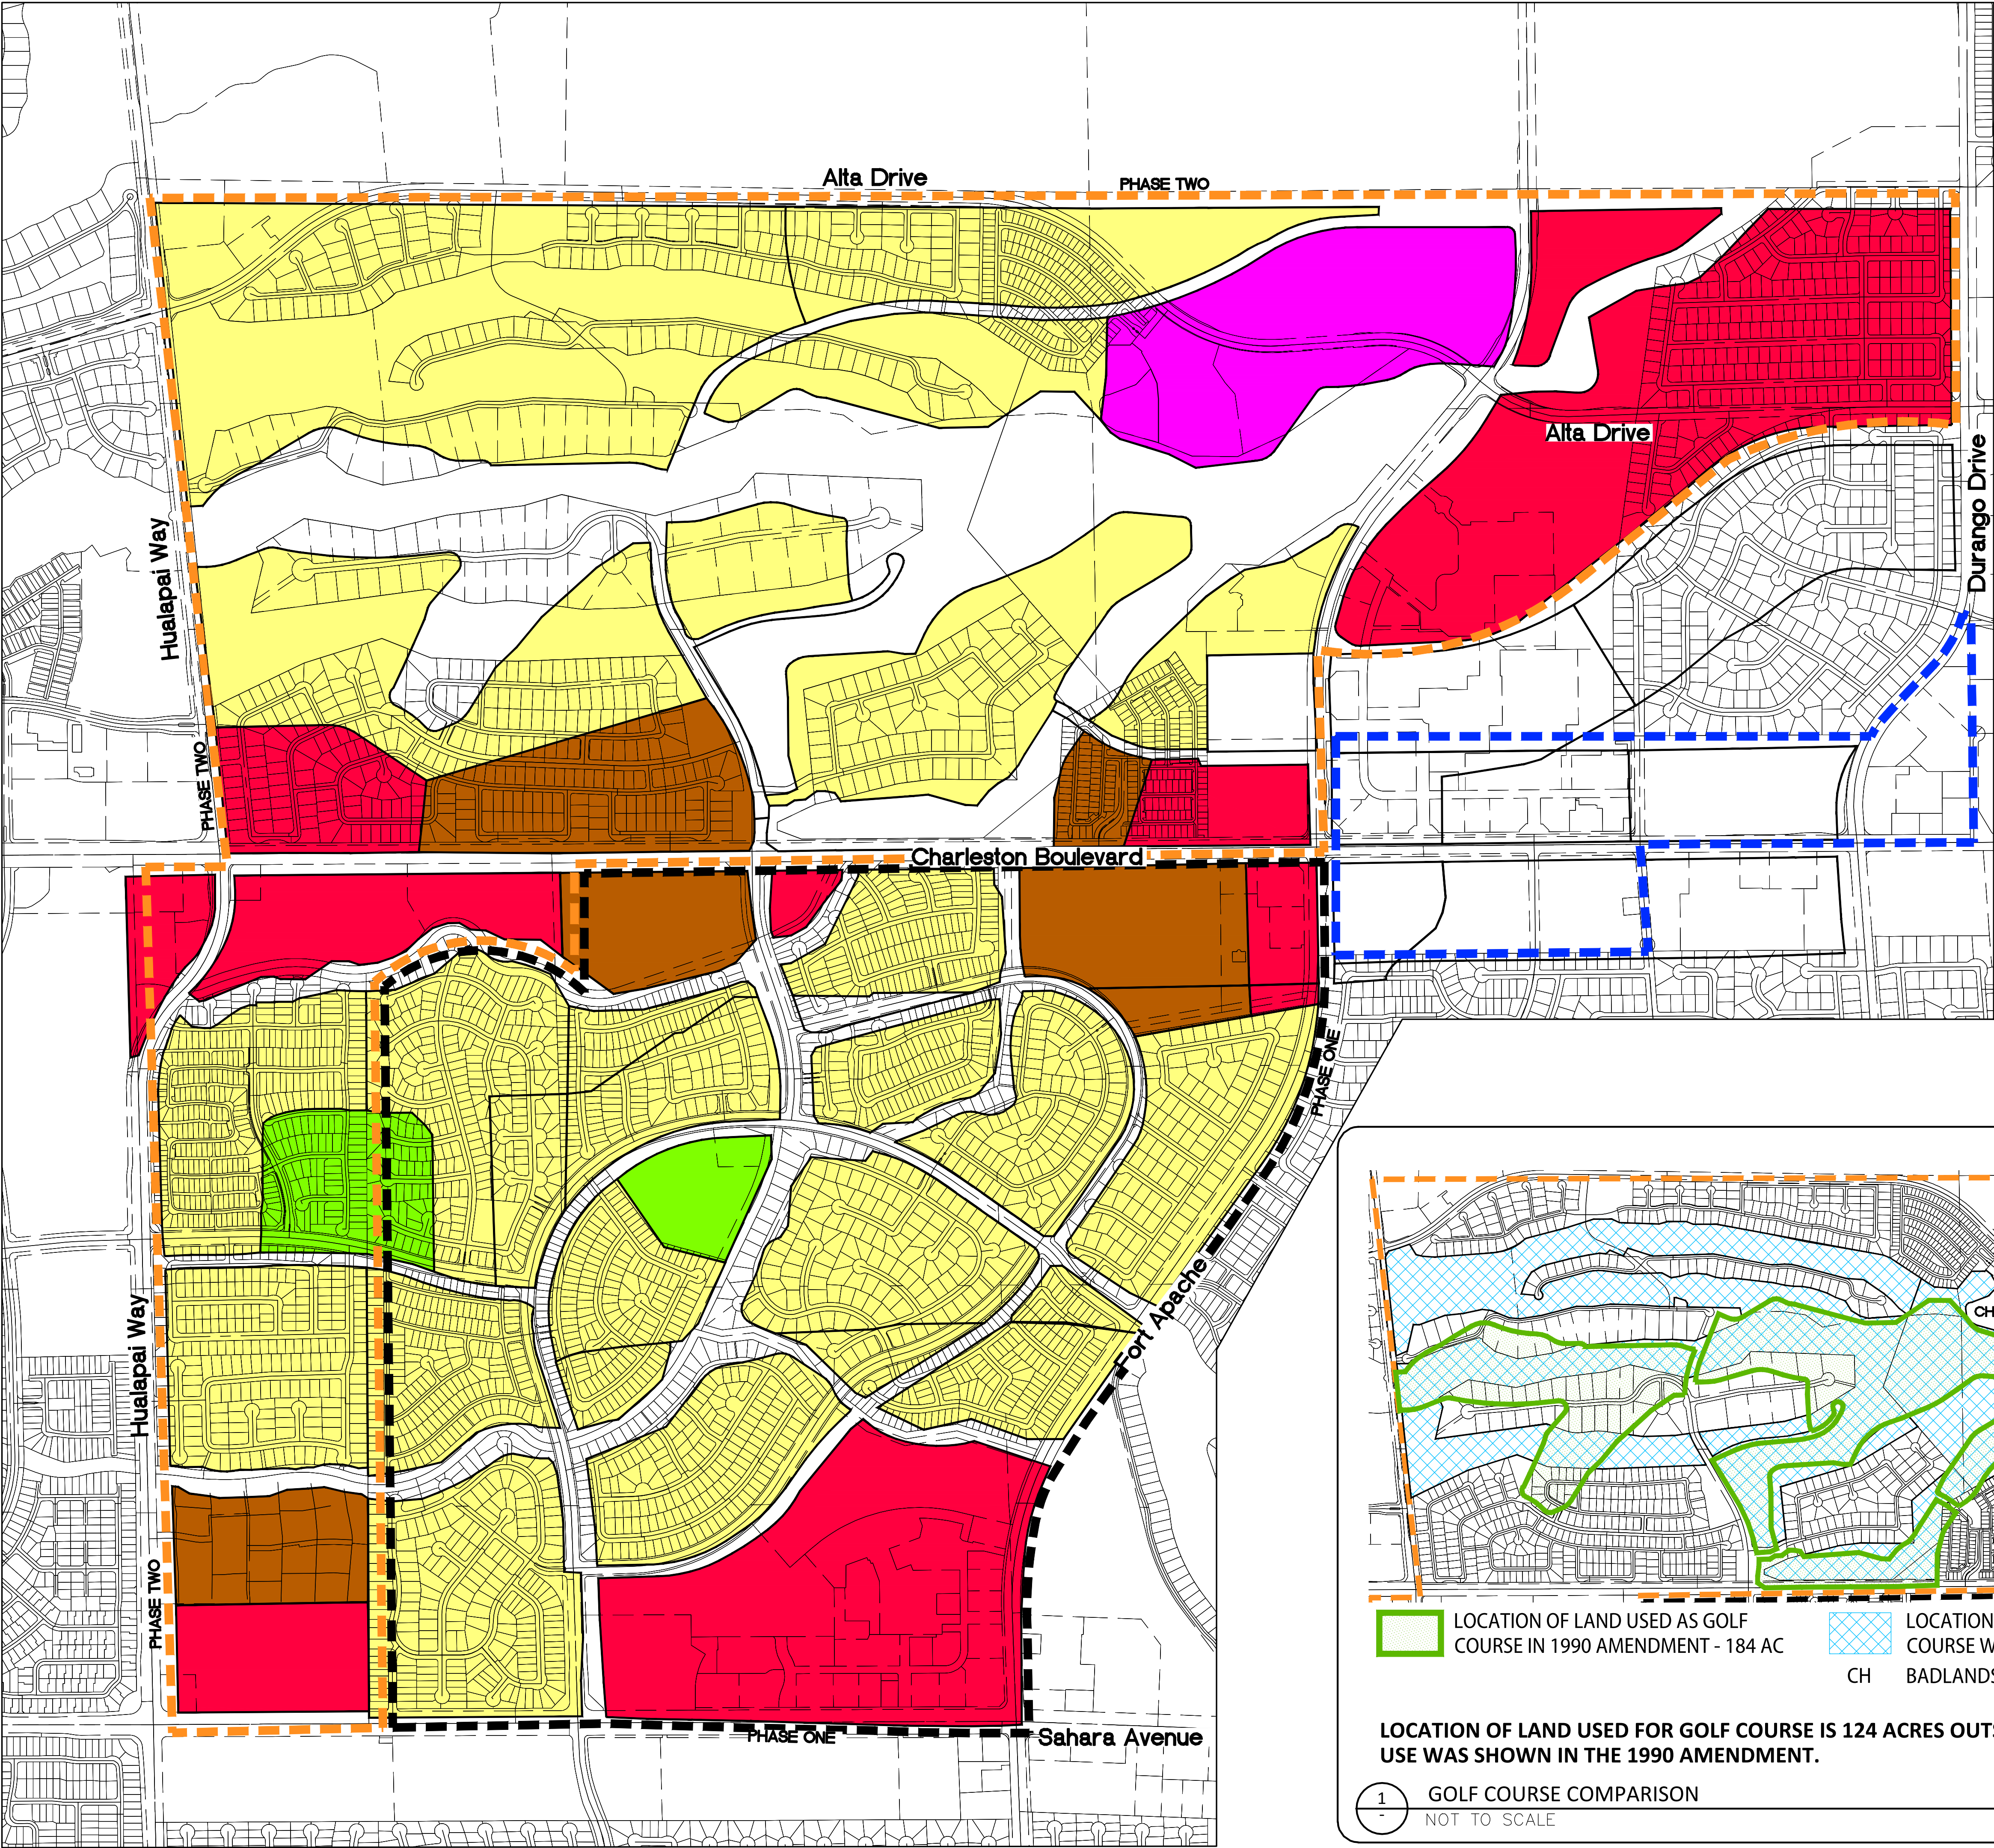

LEGEND

- PHASE ONE BOUNDARY
- PHASE TWO BOUNDARY
- DELETED FROM MASTER PLAN WITH 1990 AMENDMENT
- SINGLE FAMILY
- MULTI FAMILY
- HOTEL/RESORT
- COMMERCIAL
- SCHOOL
- GOLF COURSE/OPEN SPACE/DRAINAGE

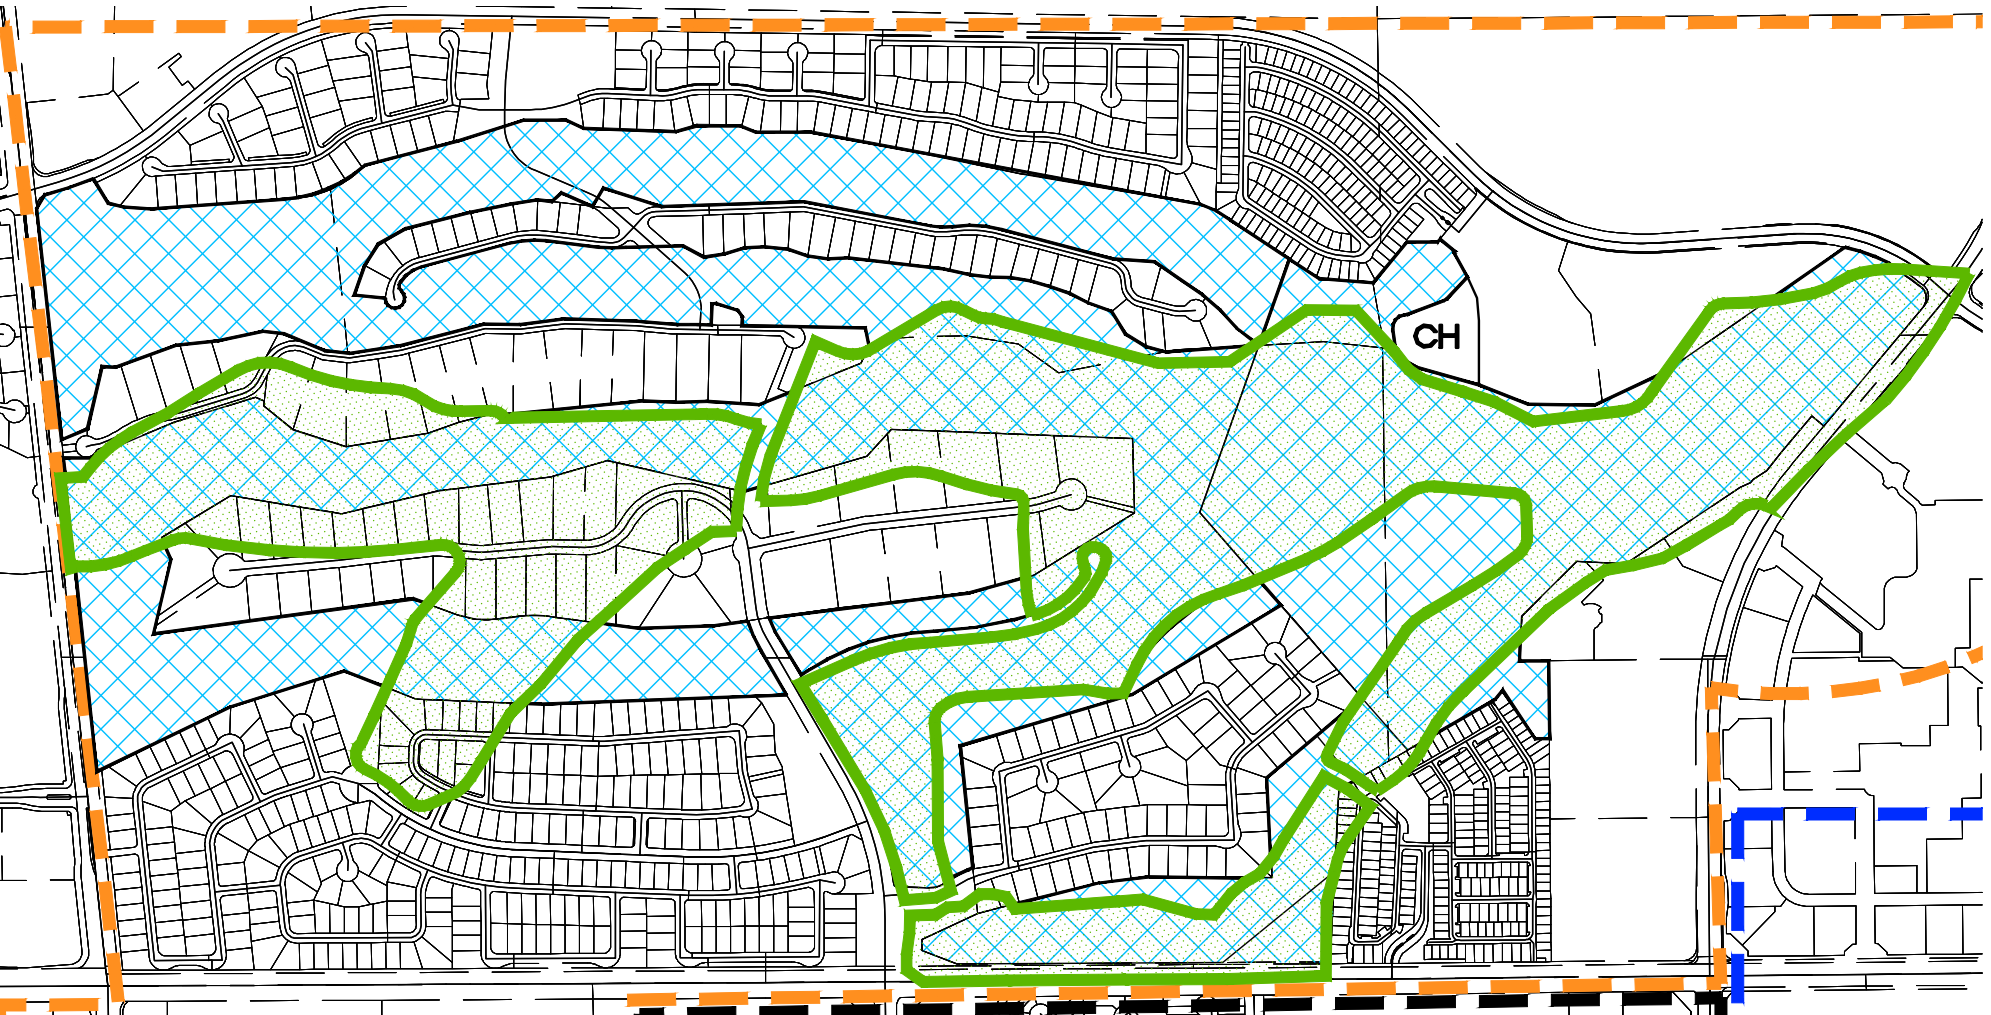

LOCATION OF LAND USED AS GOLF COURSE IN 1990 AMENDMENT - 184 AC

LOCATION OF LAND ON WHICH GOLF COURSE WAS BUILT - 250.92 AC

CH BADLANDS CLUBHOUSE - 2.37 AC

LOCATION OF LAND USED FOR GOLF COURSE IS 124 ACRES OUTSIDE OF WHERE THIS USE WAS SHOWN IN THE 1990 AMENDMENT.

1 GOLF COURSE COMPARISON

NOT TO SCALE

EXHIBIT F-1

2/22/2016

Peccole Ranch overall Conceptual Master Plan
As-Built (Exhibit D) Overlayed On The
1990 Amendment (Exhibit B)

TP-133491
06/29/16