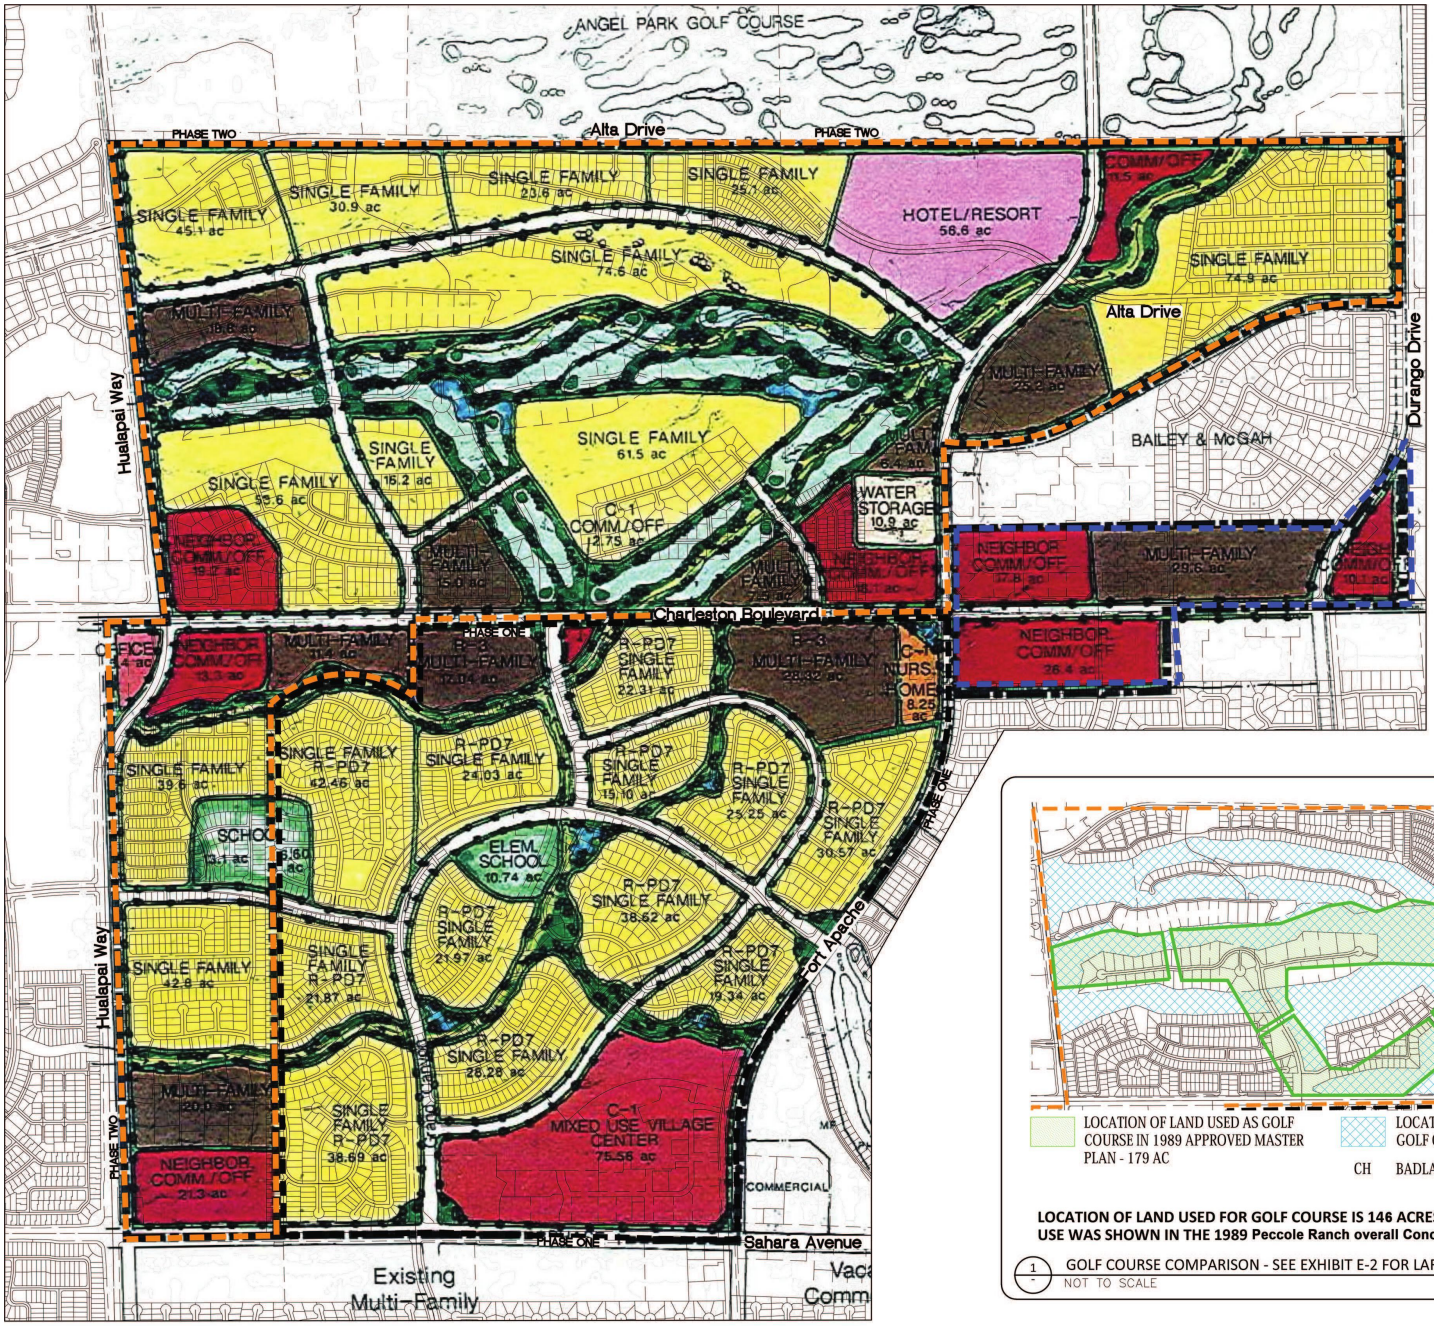

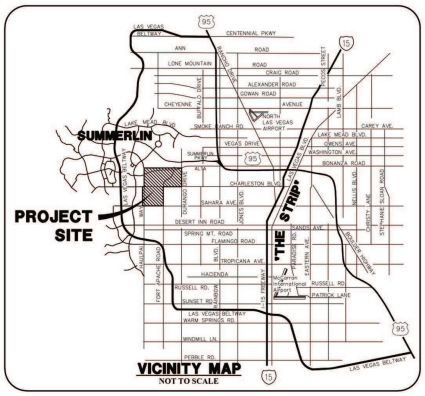

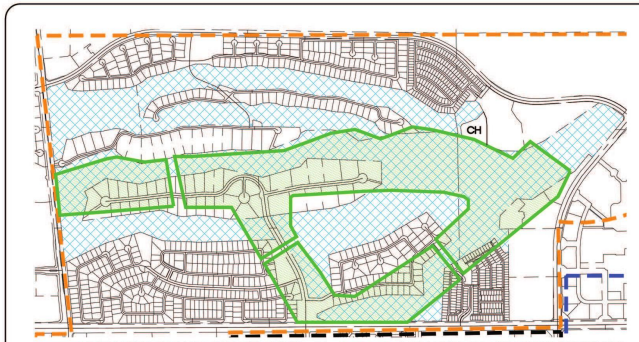

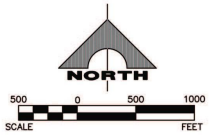

LEGEND

- PHASE ONE BOUNDARY
- PHASE TWO BOUNDARY
- DELETED FROM MASTER PLAN WITH 1990 AMENDMENT

EXHIBIT E-1

2/22/2016

As-Built (Exhibit D) Overlaid on The 1989 Peccole Ranch overall Conceptual Master Plan (Exhibit A)

PRJ-63491
06/29/16